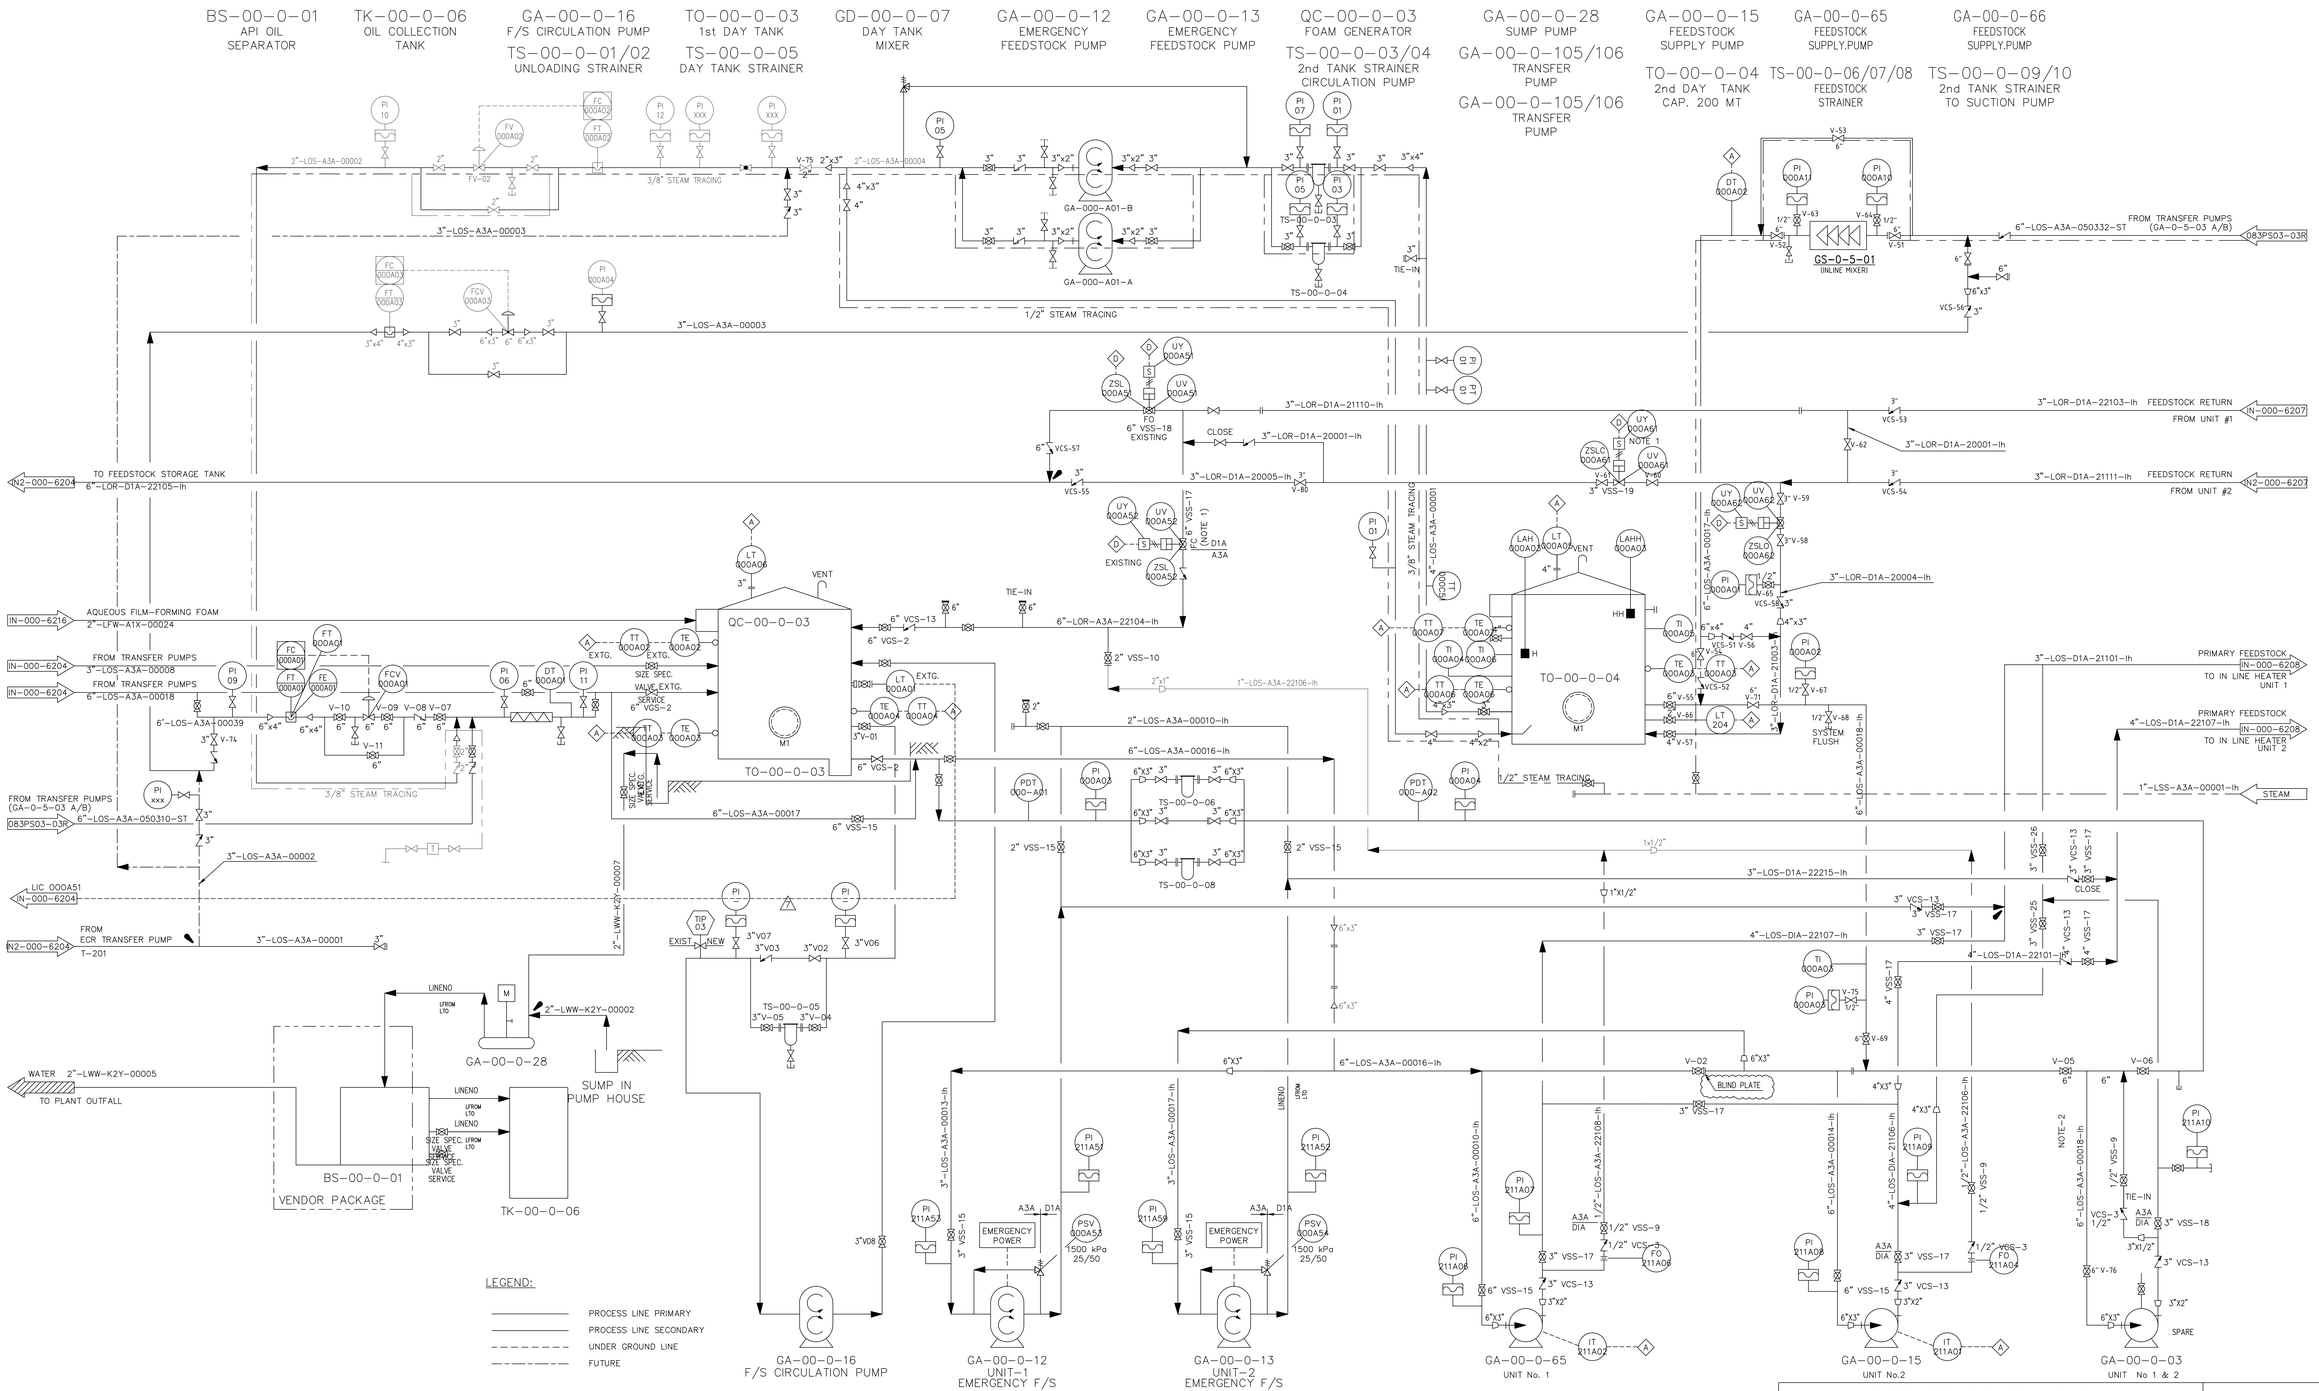

CMPS S.E. Asia Pty Limited
ENGINEERS AND PROJECT MANAGERS
A.C.N. 001 052 697
390 ST. KILDA ROAD, MELBOURNE, VICTORIA. 3004
TEL. (+ 61 3) 272 6666 FAX. (+ 61 3) 272 6611

CODE	CONDITION	TRIP POINT	INSTR. NO.	CODE	CONDITION	TRIP POINT	DWG. No.	REFERENCE DWGS.

REV.	ISSUED FOR	PROJ. NO.	W.O. NO.	APPR.	DATE
2	CONSTRUCTION RECORD	SM8063			

REV.	DESCRIPTION	BY	CHKD.	APPR.	DATE
15	BLIND PLATE	FZ	AF	–	6.25.21
14	UPDATE TAG NUMBER	FZ	TT	MR	5.25.21
13	ASBUILT DRAWING	FZ	AA	MR	12.23.20
12	LINE TRANSFER PUMP CTT	UM	BUDI	ROMY	28.11.18
11	DRAWING REVISION	UM	ISA	RFQ	19.04.17

MICROFILMED
PROJECT NO. SM8063 — WORK ORDER NO.
DESIGNED A.G./L.W. — INSTRUMENT/ELECTRICAL APPROVAL
DRAWN PP / ZL — DATE
CHECKED A.G. / GI — PROCESS APPROVAL — DATE
MECHANICAL/STRUCTURAL APPROVAL — DATE
R & D APPROVAL — DATE
PLANT APPROVAL A.MOORE 28.8.95 — DATE

THIS DRAWING IS THE PROPERTY OF P.T. CABOT INDONESIA AND IS LOANED IN CONFIDENCE FOR USE IN CONNECTION WITH OUR WORK. IT IS NOT TO BE REPRODUCED IN ANY MANNER OR SUBMITTED TO OUTSIDE PARTIES FOR EXAMINATION OR USED DIRECTLY OR INDIRECTLY FOR PURPOSES OTHER THAN THOSE FOR WHICH IT WAS FURNISHED WITHOUT WRITTEN CONSENT.

CABOT
P.T. Cabot
CILEGON
INDONESIA

PIPING AND INSTRUMENT DIAGRAM
FEEDSTOCK SUPPLY PUMPS
UNIT 2

DRAWING NUMBER IN2-000-6205 — REVISION 15